


CORTE A-A
ESC: 1:100

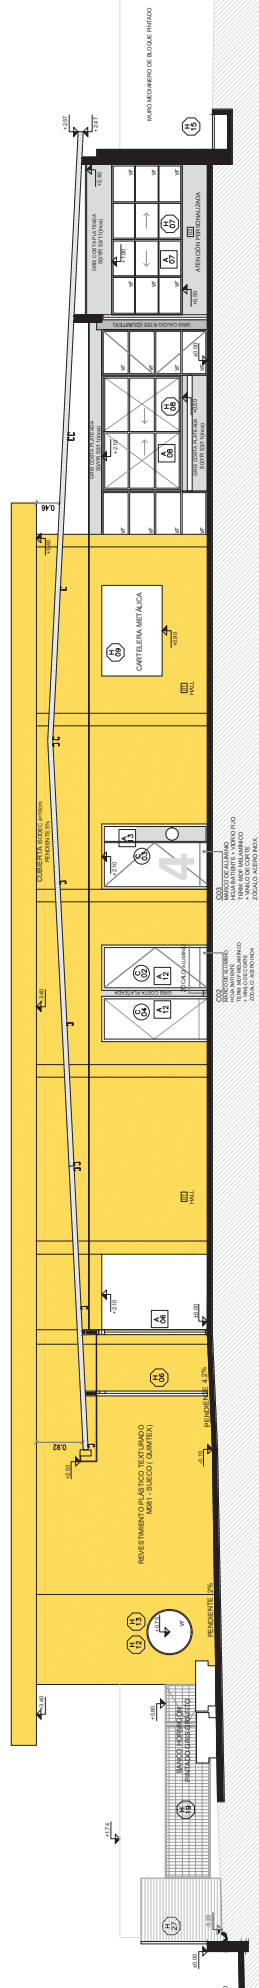

CORTE B-B
ESC: 1:100

[illegible]