


CORTE C-C
ESC: 1:100

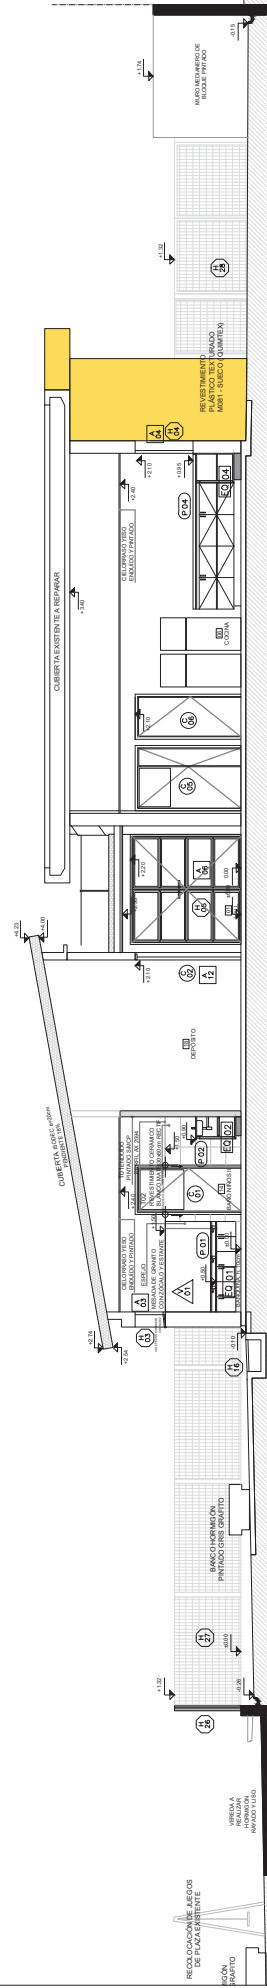

CORTE D-D
ESC: 1:100

[illegible]